Date:

Wednesday, 06/09/2006 11:05:23 AM

Hser.

Linda Lacelle

**Process Sheet** 

Customer : CU-DAR001 Dart Helicopters Services Job Number : 28424\_ : 12522 **Estimate Number** P.O. Number : NIA S.O. No. : NA 06/09/2006 This issue Prsht Rev. First Issue : NA Previous Run Written By Checked & Approved By

: SMALL /MED FAB

**Drawing Number** Project Number **Drawing Revision** 

Part Number

**Drawing Name** 

Material **Due Date**  : D35311

: UNDER REVIEW & 05.09.05

: BRACKET ASS'Y

: N/A

: 13/09/2006

2 Um: Each

**Additional Product** 

: Est Rev:A New Issue 06-09.06 EC

PRELIMINARY ISSUE

Job Number:

Comment



Seq. #: M6061T6S040 1.0



6061-T6 .040 Sheet



Comment: Qty.:

Total: 0.7944 sf(s)

6061-T6 .040 Sheet (M6061T6S040).

Batch: 1193.80

WATER JET 2.0





Comment: FLOW WATER JET

1-Cut as per Dwg D3531

Dwg Rev: Pre Prog Rev: Pre

06 09 06



3.0



PARTS AS THEY COME OFF MACHINE Comment: INSPECT



4.0 QC8



Comment: SECOND CHECK



5.0

SMALL FAB 1

SMALL & MEDIUM FAB RESOURCE 1








Comment: SMALL & MEDIUM FAB RESOURCE 1

Deburr if necessary.

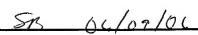

## **Dart Aerospace Ltd**

W/O:			W	ORK ORDER CHANG	SES				
DATE STEP		-PRO	-PROCEDURE CHANGE			Date	Qty	Approval Chief Eng / Prod Mgr	Approval QC Inspector
¥									
		•							
Part No		PAR #:	Fault Cate	gory:	13			Date: <u> </u>	
NCR:			VORK ORD	ER NON-CONFORM		*	u	_ Date	
						¥ <b>′</b>			<u> </u>
DATE	STEP	Description of NC Section A	Initial Chief Eng	Corrective Action Section Description Chief Eng	tion B Sign Date			Approval Chief Eng	Approval QC Inspector
							,		-
				.**					
		·							

NOTE: Date & initial all entries

•	Wednesday, 06/09/2006 11:05:23 AM Linda Lacelle		
	mer: CU-DAR001 Dart Helicopters Ser	Process Sheet  vices Drawing Name: BRA	OVET ACCIV
Custor	ner. Co-DANOUT Dan Helicopters Ser	vices Drawing Name. Bro-	ACKET ASS T
	ber: 28424	Part Number: D35	311
Job Number:		·	
Seq. #:	Machine Or Operation:	Descrip	tion :
6.0	BRAKE NC	NC BRAKE	1310130010010
			<b>                                      </b>
Co	mment: NC BRAKE		
7.0	Bend as per Dwg D3530	SB.	06/09/07
7.0	HAND FINISHING1	HAND FINISHING RESOURCE #1	
Cor	mment: HAND FINISHING RESOUR	•	
0.0	Chemical Conversion Coat	<u> </u>	06-09-14
8.0	QC3	INSPECT POWDER COAT/CHEMIC	AL CONVERSION
Cor	mment: INSPECT POWDER COAT/	CHEMICAL CONVERSION	06.09.14 2
9.0	PACKAGING 1	PACKAGING RESOURCE #1	
Cor	mment: PACKAGING RESOURCE		
	Identify a <del>nd Stock</del> Location:	2005. 022 01119	E 06.09.19 3
10.0	QC21	FINAL INSPECTION/W/O RELEASE	
Coi	mment; Inspection Level 21		47/07/07/09
Job Completion			Lr 06.09:20
	,		,
149	RT WENT TO HAI.	PART NOT APPROVED	AND NOT ALRWORTHY
		cb 07.07.13	
		antigotion to the program of the program of the control of the con	·
Ç			,

Dart	Ae	ros	pace	Ltd
------	----	-----	------	-----

W/O:		WORK ORDER CHANGES	· <del>······</del>				-3-
DATE STEP		PROCEDURE CHANGE		Date	ate Qty	Approval Chief Eng / Prod Mgr	Approval QC Inspector
16-09-07	6.1	QCS regid for budinspection. Perm. Change					
<b>16</b> 0 ·		QC 5 inspect bend.	0	06-09-07	2		06 090
: 							


Part No:	PAR #: Fault C	category:	NCR: Yes No	DQA:	Date:
	*		QA: N/C C	losed:	Date:

WORK ORDER NON-CONFORMANCE (NCR)					
ation Approval	Approval				
cation Approval Chief Eng	Approval QC Inspector				
	,				

NOTE: Date & initial all entries

# PRELIMINARY ISSUE

DESIGN	DRAWN BY	DART AEROSPACE LTD HAWKESBURY, ONTARIO, CANADA			
CHECKED	APPROVED	DRAWING NO. D3531	REV. A		
D. 255	<u> </u>		SHEET 2 OF 3		
DATE		TITLE	SCALE		
06.0	06.21	BRACKET ASSEMBLY	1:3		

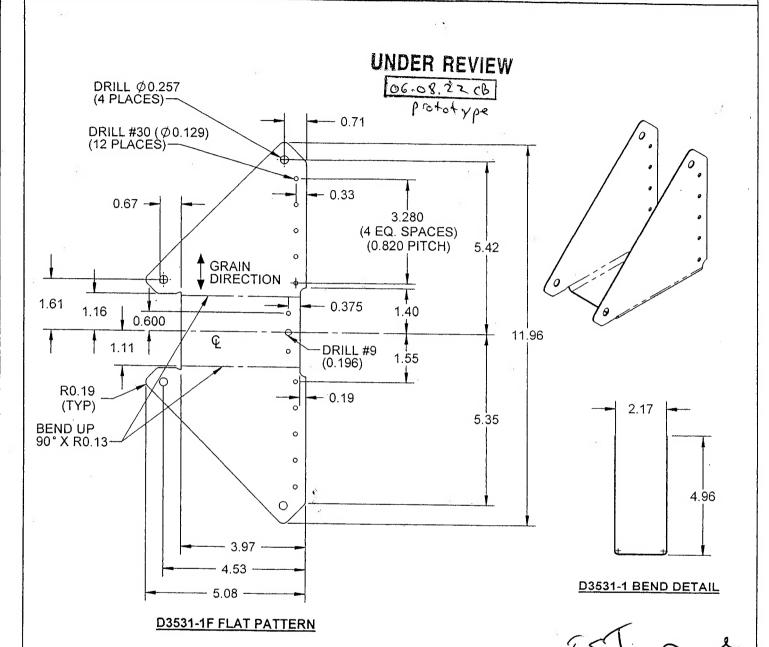

## D3531-1 BRACKET

#### NOTES:

- 1) MATERIAL: 606/1376 ALUMINUM (QQ-A-250/11) 0.040 SHEET (REF. DART-SPEC. M606176S.040)
  2) FINISH: ACID ETCH AND ALODINE PER DART QSI 005 4.1
- 3) TOLERANCES ARE PER DART QSI 018 UNLESS OTHERWISE NOTED
- 4) ALL DIMENSIONS ARE IN INCHES
- 5) BREAK ALL SHARP EDGES 0.005 TO 0.010
- 6) PART IS SYMMETRICAL ABOUT Q

#### COPYRIGHT © 2006 BY DART AEROSPACE LTD.

DART AEROSPACE LTD				Work Order:	28424
	. 3 .	4	·.	Part Number:	3531-1
Description:		100			Direct of 1
Inspection Dwg: \Re	v:			18 Car	Page 1 of 1

# FIRST ARTICLE INSPECTION CHECKLIST

X First Article X Prototype

Drawing Dimension	Tolerance	Actual Dimension	Accept	Peject	Method of Inspection	Comments
	+1-0.005,0.000	0.857	$\checkmark$		VerN	
\$ 0.129	+1-0.005,0.000	0.130	$\checkmark$		vern	
D 196	41-0.005,0.000	0.196	<b>V</b>		Vern	
5.08	+1-0.030	5.10	<b>√</b>		VEFN	
11.96	4-0.030	11.96	./		Measuring to	<u>re</u>
3.97	41-0.030	3.98	1		verN	
4.53	+1-0.030	4.53	<b>√</b>		VERN	
	1.					
10						34
			4.7			
						in .
	·	· ·	ri .			
				?		
				4		
						·
				<del> </del>		
		1/2				
				-		
		***				

Measured by:	ml: W	Audited by:	Prototype Approval:
	B 09 B	Date:	Date:
Duto.	W 1 00		

Rev Date C	hange	Revised by	Approved
	ew Issue	KJ/JLM	

KEURINGSRAPPORT COPPER AND BRASS SALES CORPORATE SERVICES DIVISION KLANT SOUTHFIELD, MI USA PO3944 (COPPER'S PO#CC1837) 58848/01 V/0080151422 UW ORDERNUMMER ONS ORDERNUMMER DOCUMENT NUMMER SPECIFICATIES: ALU SHEETS (STENC A A 60612T6 AFMETINGEN: 144" X 48" X 10 04" Corus Aluminium N.V. A. Stodetaan 87, 2570 Duffel - Belgium Tel. 32 (0)15 30 21 11 - Fax (0)15 30 27 94 ARTIKEL NR .: CHEMISCHE ANALYSE (%) ROL-GEUT-NUMMER NUMMER -------------------0,04 0,15 0,25 0,15 0,35 0,01 0,09 0,09 7124901 0,67 001 7124901 002 ANDERE : ELK TOTAAL MIN 0,05 MAX 0,15 MAX MECHANISCHE EIGENSCHAPPEN 1 N/MM2 = 1 MPA = 0.1 HBAR = 0.102 KG/MM2 = 0.145 KSI A = ACHTER /M = MIDDEN /V = VOOR /O = RANDOM NUMMER RM RP02 KSI KSI 35 10 42 XAM 16 15 16 16 16 39 39 39 COPPER AND BRASS SALES SOLD TO:

PROD. REF. : 0000175932/001

NRBST : 58848/01

PAGINA :

DOC: V/0080151422

DATUM : 2005-04-18